



WATER-RIGHT DOCKET

Glen Canyon National Recreation Area

Docket No: 8

CASTLE BUTTE WELL

State Water Rights Documentation

00-00-0000: completion report of construction project: drilling of test well(s)

Form 10-174
(Rev. 8-56)

UNITED STATES DEPARTMENT OF THE INTERIOR
NATIONAL PARK SERVICE

COMPLETION REPORT OF CONSTRUCTION PROJECT

REGION <i>South West</i>	AREA <i>Glen Canyon N.R.A.</i>	COUNTY <i>San Juan</i>	STATE <i>Utah</i>
PROJECT OR JOB TITLE <i>Drilling of Test Well(s)</i>		PCP NO. <i>WR-11</i>	
LOCATION IN AREA <i>Castle Butte</i>		MASTER PLAN NO.	BUILDING NO.
WORKING DRAWING NO. AND TITLE <i>Job. No. 0903</i>			
APPROPRIATION TITLE AND SYMBOL <i>14X1035 Construction</i>		WORK ORDER NO. <i>SSC-WR-67B</i>	
CONTRACT NO. <i>14-10-7-973-84</i>		DATE WORK STARTED <i>June 14, 1967</i>	DATE WORK COMPLETED <i>March 26, 1968</i>
NAME OF CONTRACTOR <i>Perry Bros. Drilling Co.</i>		ADDRESS <i>2033 N. Navajo Drive Flagstaff, Arizona 86001</i>	

COST ANALYSIS

CONSTRUCTION ITEMS	QTY.	UNIT COST IN PLACE	TOTAL COST IN PLACE
<i>USGS Supervision 2,500</i>		<i>DRILLING WATER WELL</i>	<i>21,551.00</i>
<i>LWSSC</i>		<i>WATER ANAL.</i>	<i>120.00</i>
<i>Contract (Perry Bros) \$45,503.00</i>		<i>PRINTING SPECIFICATIONS</i>	<i>64.59</i>
<i>Depth 1785'</i>		<i>INVESTIGATION</i>	<i>250.00</i>
<i>Salty Water</i>			
<i>Cased 1582'</i>			
<i>Change Order No 1 3,678.00</i>			
<i>C.O. FY67</i>			
<i>FY68 2500</i>			
		TOTAL	\$21,985.57

SUMMARY OF EXPENDITURES

PERSONAL SERVICES	EQUIPMENT	MATERIALS AND SUPPLIES
OTHER		

CHANGE ORDERS

ORIGINAL CONTRACT AMOUNT <i>\$69,105.00</i>	FIRST <i>\$3,678.00</i>	SECOND	THIRD
FINAL CONTRACT AMOUNT <i>\$49,181.00</i>	FOURTH	FIFTH	SIXTH

THIS PROJECT OR JOB HAS BEEN COMPLETED IN ACCORDANCE WITH
APPROVED DRAWINGS, SPECIFICATIONS, AUTHORIZED CHANGES

SUBMITTED BY (Name and title)	DATE
APPROVED BY (Name and title)	DATE

(ATTACH NARRATIVE STATEMENT, PHOTOGRAPHS, AND "AS BUILT" DRAWINGS TO THIS FORM)



THE STATE OF UTAH
OFFICE OF STATE ENGINEER
SALT LAKE CITY

HUBERT C. LAMBERT
STATE ENGINEER

May 31, 1967

Issue Date: May 31, 1967
Expiration Date: November 30, 1967

U. S. Dept. of Interior
National Park Service
San Francisco Planning and Service Center
Office of Land and Water Rights
450 Golden Gate Ave., Box 36025
San Francisco, California 94102

Attention: William E. Fields, Supervisory Hydraulic Engineer

Gentlemen:

RE: TEST WELL - SAN JUAN COUNTY

Reference is made to your letter received in this office on May 29, 1967, in which you request permission to drill three test wells for exploratory purposes. One of these wells is to be drilled in Glen Canyon National Recreation Area in SE 1/4 Sec. 25, T35S, R13E, SL&M, to a depth in excess of 2000 feet.

This is permission to proceed with the drilling of such a test hole or well with the understanding that no more water is to be diverted from such a test well than is necessary to determine the availability of a good water supply. This letter in no way grants you permission to proceed to divert and use water from this test hole for any purposes whatsoever.

Following completion of the drilling and testing the casing is to be capped until such time as a proper application has been ^{filed} with the State Engineer and approval given.

The driller must be bonded and have a current permit from the State Engineer. Before commencing, he must give this office notice as to the day he will begin drilling. Also, within 30 days after the test hole has been completed or abandoned, he must file a well driller's report. Such a report is to contain accurate and complete information regarding the work done, and become part of the files in this office pertaining to this test hole.

This is permission for a licensed driller to begin drilling this test hole.


Please note that the expiration date of this letter is November 30, 1967.

Respectfully,

Donald G. Stewart,
DIRECTING ENGINEER, APPROPRIATIONS.

me

Glen Canyon

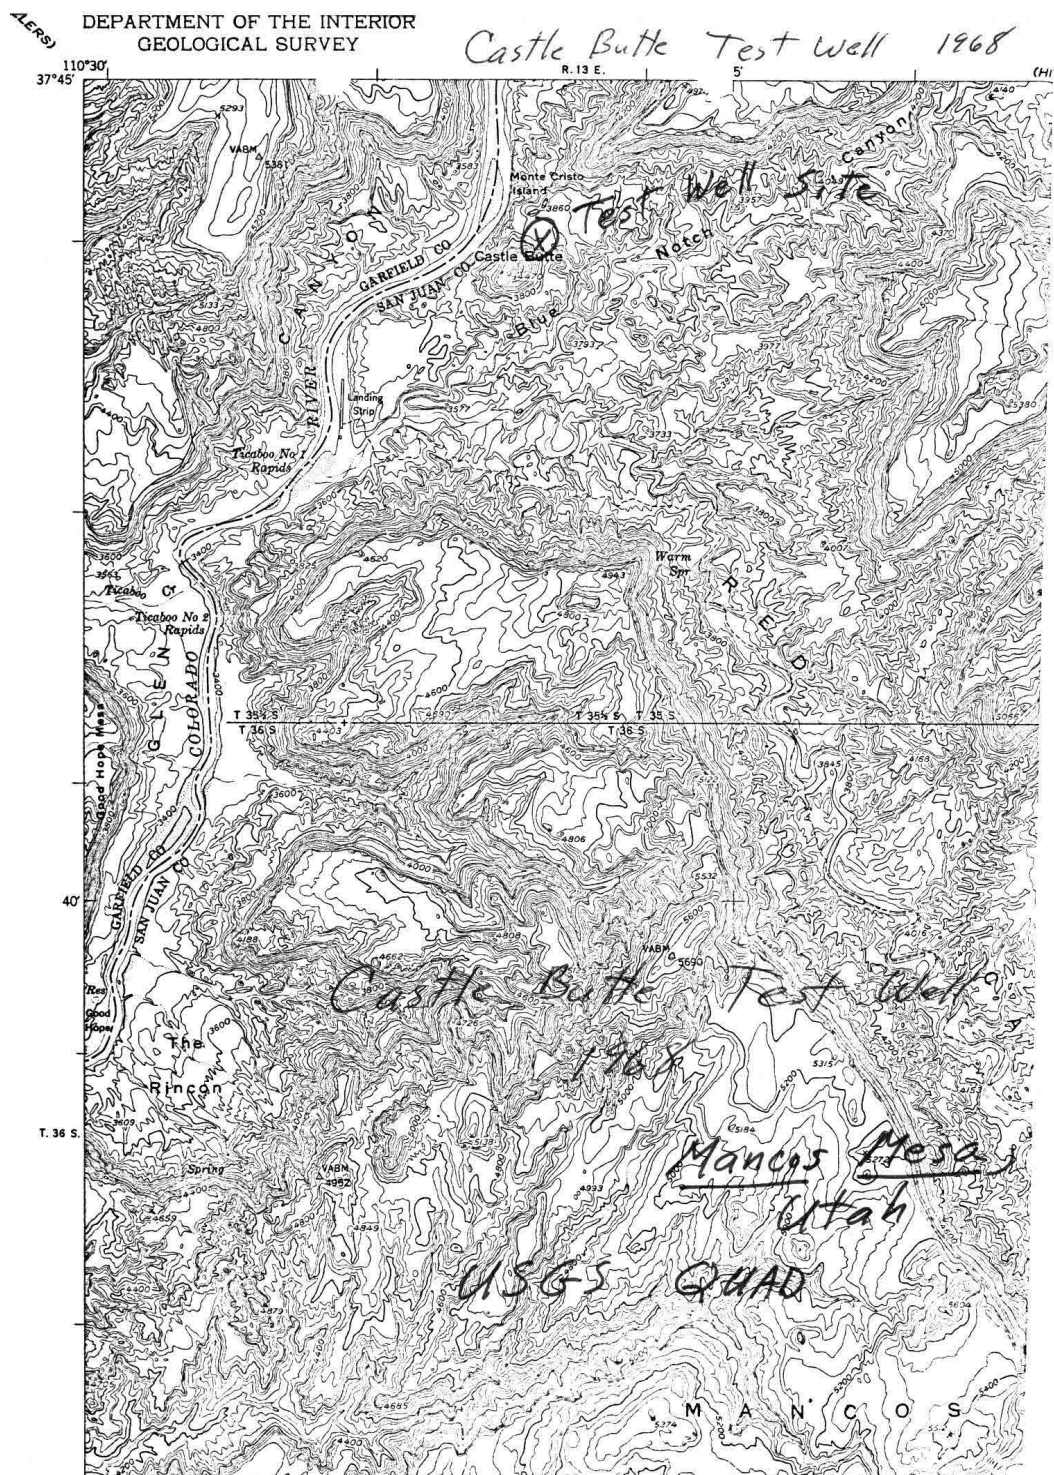

Docket Information

Number of Documents in Docket 3

Documents Dated from 5/31/1967 to 6/15/1968

Docket Compiled: 3/23/2011