



WATER-RIGHT DOCKET

Grand Teton National Park

Docket No: 43

WOLFF DITCH, SPREAD CREEK

Preliminary Docket Information

00-00-0000: water right record

WATER RIGHT RECORD

43

Docket Number 43

Alien WR Number

Water Use Map NP-GT 2174

IDENTIFICATION NO: GRTE R 1 3 4 4 1 1 4 B F 4 3 Sheet Number 6

DITCH/WATER SYSTEM: WOLFF DITCH

SOURCE OF SUPPLY: Spread Creek, Tributary of the Snake River

LOCATION:

Legal description and tie:

(Point of Diversion)

Headgate: N 61° 9' E, 752 feet from the southwest corner of Section 13,
Township 44 North, Range 114 West.

WATER RIGHT:

Appropriator: J. H. Uhl

Certificate Record Number: 32-286

Permit Number: 1653

Date of priority: November 11, 1897

Quantity of Water: 0.57 C.F.S.

Purpose: Irrigation

Irrigate Land Description:

(T 44 N, R 114 W)

40 acres - NW $\frac{1}{4}$ of the SE $\frac{1}{4}$ of Section 1

SUMMARY OF STATUS:

The above land was conveyed to the United States of America by the Jackson Hole Preserve, Incorporated, as contained in National Park Service Deed Number 2, December 16, 1949.

All rights, herein, were assigned to Jude V. Allen, as contained in Assignment Record Book 1, Page 184, State Engineers Office, State of Wyoming.

WATER RIGHT RECORD

Docket Number 45

Alien WR Number

Water Use Map NP-GT 2174

Sheet Number 6

IDENTIFICATION NO: GRTE R 1 3 4 4 1 1 4 F F 4 5

DITCH/WATER SYSTEM: WOLF DITCH

SOURCE OF SUPPLY: Spread Creek, Tributary of the Snake River

LOCATION:

Legal description and tie:
(Point of Diversion)

Headgate Location: N 61° 9' E, 752 feet from the southwest corner of
Section 13, Township 44 North, Range 114 West.

WATER RIGHT:

Appropriator: J. D. Ferrin

Certificate Record Number: 41-3

Permit Number: 1653

Date of priority: November 11, 1897

Quantity of Water: 2.28 c.f.s.

Purpose: Irrigation and Domestic

Irrigate Land Description:

(T 44 N, R 114 W)

40 acres - NW $\frac{1}{4}$ of the NW $\frac{1}{4}$ of Section 3

40 acres - NE $\frac{1}{4}$ of the NW $\frac{1}{4}$ of Section 3

40 acres - NW $\frac{1}{4}$ of the NE $\frac{1}{4}$ of Section 3

40 acres - NE $\frac{1}{4}$ of the NE $\frac{1}{4}$ of Section 4

160 acres - Total

SUMMARY OF STATUS:

The above land was conveyed to the United States of America by the
Jackson Hole Preserve, Incorporated, as contained in National Park Service
Deed Number 2.

WATER RIGHT RECORD

Docket Number 45

Alien WR Number

Water Use Map NP-GT 2174

Sheet Number 6

IDENTIFICATION NO: GRTE R 1 3 4 4 1 1 4 E F 4 5

DITCH/WATER SYSTEM: WOLFF DITCH

SOURCE OF SUPPLY: Spread Creek, Tributary of the Snake River

LOCATION:

Legal description and tie:

(Point of Diversion)

Headgate: N 61° 9' E, 752 feet from the southwest corner of Section 13,
Township 44 North, Range 114 West.

WATER RIGHT:

Appropriator: Marie Wolff

Certificate Record Number: 58-109

Permit Number: 1653

Date of priority: November 11, 1897

Quantity of Water: 0.57 C.F.S.

Purpose: Irrigation

Irrigate Land Description:

(T 44 N, R 114 W)

40 acres - NE $\frac{1}{4}$ of the SE $\frac{1}{4}$ of Section 4.

SUMMARY OF STATUS:

The above land was conveyed to the National Park Service by Eileen M. Hunter, By National Park Service Deed Number 33, dated April 29, 1958.

Subject deed includes: "all water and ditch rights and rights of way therefore. . ."

WATER RIGHT RECORD

Docket Number 47
Alien WR Number
Water Use Map NP-GT 2174
Sheet Number 6

IDENTIFICATION NO: GRTE R 1 3 4 4 1 1 4 H F 4 7

DITCH/WATER SYSTEM: WOLFF DITCH

SOURCE OF SUPPLY: Spread Creek, Tributary of the Snake River

LOCATION:

Legal description and tie:
(Point of Diversion)
Headgate: N 61° 9' E, 752 feet from the southwest corner of Section 13,
Township 44 North, Range 114 West.

WATER RIGHT:

Appropriator: Otto Kusche
Certificate Record Number: 32-287
Permit Number: 1653
Date of priority: November 11, 1897
Quantity of Water: 2.28 C.F.S.
Purpose: Irrigation, Stock and Domestic
Irrigate Land Description:
(T 45 N, R 114 W)
160 acres - SW $\frac{1}{4}$ of Section 35

SUMMARY OF STATUS:

The above land was conveyed to the United States of America by the Jackson Hole Preserve, Incorporated, as contained in National Park Service Deed Number 2, December 16, 1949.

WATER RIGHT RECORD

Docket Number 48

Alien WR Number

Water Use Map NP-GT 2174

Sheet Number 6

IDENTIFICATION NO: GRTE R 1 3 4 4 1 1 4 I F 4 8

DITCH/WATER SYSTEM: WOLFF

SOURCE OF SUPPLY: Spread Creek, Tributary of the Snake River

LOCATION:

Legal description and tie:
(Point of Diversion)

Headgate: N 61° 9' E, 752 feet from the southwest corner of Section 13,
Township 44 North, Range 114 West.

WATER RIGHT:

Appropriator: Emile Wolff

Certificate Record Number: 32-285

Permit Number: 1653

Date of priority: November 11, 1897

Quantity of Water: 2.67 C.F.S.

Purpose: Irrigation

Irrigate Land Description:

(T 44 N, R 114 W)

80 acres - N $\frac{1}{2}$ of the SW $\frac{1}{4}$ of Section 3

27 acres - SE $\frac{1}{4}$ of the SE $\frac{1}{4}$ of Section 4

80 acres - N $\frac{1}{2}$ of the SW $\frac{1}{4}$ of Section 1

187 acres - Total

SUMMARY OF STATUS:

80 acres, in Section 1, to wit: the N $\frac{1}{2}$ of the SW $\frac{1}{4}$, was conveyed to the United States of America by the Jackson Hole Preserve, Incorporated, as contained in National Park Service Deed Number 2, December 16, 1949.

27 acres in Section 4, to wit: in the SE $\frac{1}{4}$ of the SE $\frac{1}{4}$, was conveyed to the National Park Service by Eileen M. Hunter, as contained in National Park Service Deed Number 33, April 29, 1958.

Grand Teton National Park

Water Right Docket No. 43

INDEX

1. General Water Use Plan, NP-GT 2174, Sheet #6.
2. Map supporting Application - Permit 5279E and 5380R.
3. Certificates R-1-390 and 61-444 for Permits 5279E and 5380R.
4. Certificate for ~~Permit 1653~~. Certificate No. 32-286
5. Map supporting Application - Permit 12188.
6. Certificate 37-564 for Permit 12188.
7. Map supporting Application - Permit 12187.
8. Certificate 37-559 for Permit 12187.

*See
Related
Dockets*

Grand Teton National Park

Water Right Docket No. 45

INDEX

1. General Water Use Plan, NP-GT 2174, Sheet #6.
2. File map for Permit No. 2090E.
 - a. Certificate 37-591 for Permit 2090E.
3. File map for Permit No. 1653.
 - a. Certificate 41-3 for Permit 1653.
4. File map for Permit No. 1653.
 - a. Certificate 58-109 for Permit 1653.
5. File map for Permit No. 3086.
 - a. Certificate 32-288 for Permit 3086.
 - b. Application for Permit 3086.
6. Certificate 45-333 for Permit 4419E.
7. File map for Permit No. 12364.
 - a. Application for Permit 12364.
 - b. Certificate 37-601 for Permit 12364.
8. Application for Permit No. 8692.
 - a. File map for Permit 8692.
 - b. Certificate 32-296 for Permit 8692.

*See Related
Dockets*

Grand Teton National Park

Water Right Docket No. 47

INDEX

1. General Water Use Plan, NP-GT 2174, Sheet #6.
2. File map for Permit 19719.
 - a. Certificate No. 61-275.
3. Certificate 40-193 for Permit No. 2090E.
4. Certificate ~~32-287~~ for Permit No. 1653.
5. Certificate 37-590 for Permit No. 2090E.
6. File map for Permit 12833.
 - a. Certificate No. 43-92.

*Check Related
Dockets*

Missing Certificate:

Permit 11195

Certificate 37-593

Grand Teton National Park

Water Right Docket No. 48

INDEX

1. General Water Use Plan, NP-GT 2174, Sheet #6.
2. File map for Application - Permit 2586E.
 - a. Certificate 41-4 for Permit 2586E.
3. File map for Application - Permit 2759E.
 - a. Certificate 41-448 for Permit 2586E.
4. Certificate 32-285 for Permit 1653.

see related Dockets

Missing Certificate:

Permit 11195

Certificate 37-594

Certificate of Appropriation of Water

WHEREAS, Marie Wolff has presented to the Board of Control of the State of Wyoming proof of the appropriation of water from Spread Crank, tributary of Snake River through the Wolff Ditch under Permit No. 1653 for irrigation of the lands herein described, lying and being in Teton County, Wyoming

NOW KNOW YE, That the State Board of Control, under the provisions of Chapter 122, Wyoming Revised Statutes, 1931, has, by an order duly made and entered on the 10th day of June, A. D. 1941, in Order Record No. 10, Page 323, determined and established the priority and amount of such appropriation as follows:

Name of Appropriator Marie Wolff; Postoffice Address Elk, Wyoming;
Date of Appropriation November 11, 1937; Total Acreage Forty (40) Acres;
Amount of Appropriation 0.57 cu. ft. per sec.; Description of land to be irrigated and for which this appropriation is determined and established:

TWP.	RANGE	SEC.	NE $\frac{1}{4}$				NW $\frac{1}{4}$				SW $\frac{1}{4}$				SE $\frac{1}{4}$				TOTAL
			NE $\frac{1}{4}$	NW $\frac{1}{4}$	SW $\frac{1}{4}$	SE $\frac{1}{4}$	NE $\frac{1}{4}$	NW $\frac{1}{4}$	SW $\frac{1}{4}$	SE $\frac{1}{4}$	NE $\frac{1}{4}$	NW $\frac{1}{4}$	SW $\frac{1}{4}$	SE $\frac{1}{4}$	NE $\frac{1}{4}$	NW $\frac{1}{4}$	SW $\frac{1}{4}$	SE $\frac{1}{4}$	
44 N	114 W	4													40				40

The right to water hereby confirmed and established is limited to irrigation----- and the use is restricted to the place where acquired and to the purpose for which acquired; rights for irrigation not to exceed one cubic foot of water per second for twenty acres of land for which the appropriation is herein determined and established.

IN TESTIMONY WHEREOF, I, L. C. BISHOP, President of the State Board of Control, have hereunto set my hand this 10th day of June, A. D. 1941, and caused the seal of said Board to be hereunto affixed.
At: Elk Ex officio Secretary. L. C. Bishop President

THE STATE OF WYOMING, }
COUNTY OF TETON. } ss. AFFIDAVIT

Marie Wolf, a resident of Teton County, Wyoming, formerly
a resident of Uinta and Lincoln Counties, Wyoming, being first
duly sworn upon her oath says:

That the Wolf ditch, under permit 1653, taking water from
Spread Creek, a tributary of Snake River was completed in 1898,
and the date of appropriation under said ditch was of date November
11, 1897; that from 1898 up to the present time water from said
Wolf ditch was applied to beneficial use for the irrigation of
the following described lands of the original homestead entry of
Emil Wolf, her husband:

NE $\frac{1}{4}$ SE $\frac{1}{4}$ Section 4, Township 44 North Range
114 W., Wyoming,

and has been used thereon for exclusive irrigation of said lands
each year since the date of the completion of the Wolf ditch in
1898; that I am the sole and only owner of said lands.

Marie Wolf

Subscribed and sworn to before me this 9th day of October, 1939.



UNITED STATES COMMISSIONER
DISTRICT OF WYOMING
My Commission Expires Aug. 17, 1942

President

11.119

THE STATE OF WYOMING

CERTIFICATE OF APPROPRIATION OF WATER

CERTIFICATE RECORD No. 32 PAGE 288 ✓

WHEREAS, Otto Kuscha has presented to the Board of Control of the State of Wyoming proof of the appropriation of water from Spread Creek tributary of Snake River through the Wolff Ditch under Permit No. 1653 for irrigation of the lands herein described, lying and being in Uinta County, Wyoming, and for stock and domestic purposes.

NOW KNOW YE, That the Board of Control, under the provisions of Division 1, Title 9, Chapters 10 and 14 of the Revised Statutes of Wyoming, 1899, has, by an order duly made and entered on the 17th day of November, A. D. 1911, in Order Record No. 4 Page 504, determined and established the priority and amount of such appropriation as follows:

Name of Appropriator Otto Kuscha; Postoffice Address Elk, Wyoming;
Amount of Appropriation 2.28 cu. ft. per sec.; Date of Appropriation November 11, 1897; Description of land to be irrigated and for which this appropriation is determined and established; Total Acreage One hundred sixty (160) acres.
160 A. S½ Section 35, Township 45 North, Range 114 West.

The right to water hereby confirmed and established is limited to irrigation, and for stock and domestic purposes. and the use is restricted to the place where acquired and to the purpose for which acquired; rights for irrigation not to exceed one cubic foot per second for each seventy acres of land for which appropriation is herein determined and established.

IN TESTIMONY WHEREOF, I, A. J. Farshall, President of the State Board of Control, have hereunto set my hand this JAN 24 1912 day of _____, A. D. 19____, and caused the seal of said Board to be hereunto affixed.

ATTEST: LOUISE JABELMANN, Secretary. A. J. Farshall, President.

11.117

THE STATE OF WYOMING

CERTIFICATE OF APPROPRIATION OF WATER

CERTIFICATE RECORD No. 332 PAGE 385

WHEREAS Emile Wolff has presented to the Board of Control of the State of Wyoming proof of the appropriation of water from Spread Creek tributary of Snake River through the Wolff Ditch under Permit No. 1653 for irrigation of the lands herein described, lying and being in Uinta County, Wyoming,

NOW KNOW YE, That the Board of Control, under the provisions of Division 1, Title 9, Chapters 10 and 14 of the Revised Statutes of Wyoming, 1899, has, by an order duly made and entered on the 17th day of November, A. D. 19 11, in Order Record No. 4 Page 504, determined and established the priority and amount of such appropriation as follows:

Name of Appropriator Emile Wolff; Postoffice Address Elk, Wyoming;
Amount of Appropriation 2.67 cu. ft. per sec.; Date of Appropriation November 11, 1897; Description of land to be irrigated and for which this appropriation is determined and established; Total Acreage One hundred eighty-seven (187) acres.

80 A. N $\frac{1}{2}$ SW $\frac{1}{4}$ Sec. 3, Tp. 44 N. R. 114 W.

27 A. SE $\frac{1}{4}$ SW $\frac{1}{4}$ Sec. 4, " " " " "

80 A. N $\frac{1}{2}$ SW $\frac{1}{4}$ Sec. 1, " " " " "

187 A. Total acreage.

The right to water hereby confirmed and established is limited to irrigation and the use is restricted to the place where acquired and to the purpose for which acquired; rights for irrigation not to exceed one cubic foot per second for each seventy acres of land for which appropriation is herein determined and established.

IN TESTIMONY WHEREOF, I, A. J. Farshall, President of the State Board of Control, have hereunto set my hand this JAN 24 1912 day of, A. D. 19, and caused the seal of said Board to be hereunto affixed.

ATTEST: LOUISE FAREHAMANT

Secretary

A. J. Farshall

President.

CERTIFICATE OF APPROPRIATION OF WATER

CERTIFICATE RECORD NO. 109 PAGE 10

WHEREAS, J. H. Uhl has presented to the Board of Control of the State of Wyoming proof of the appropriation of water from Spread Creek tributary of Snake River through the Wolff Ditch under Permit No. 1653 for irrigation of the lands herein described, lying and being in Uinta County, Wyoming,

NOW KNOW YE, That the Board of Control, under the provisions of Division 1, Title 9, Chapters 10 and 14 of the Revised Statutes of Wyoming, 1899, has, by an order duly made and entered on the 17th day of November, A. D. 19 11, in Order Record No. 4 Page 504, determined and established the priority and amount of such appropriation as follows:

Name of Appropriator J. H. Uhl; Postoffice Address Elk, Wyoming;
Amount of Appropriation 0.57 cu. ft. per sec.; Date of Appropriation November 11, 1897; Description of land to be irrigated and for which this appropriation is determined and established; Total Acreage Forty (40) acres.

40 A. NW $\frac{1}{4}$ SE $\frac{1}{4}$ Sec. 1, Tp. 44 N. R. 114 W.


For assignment of all rights herein to Jule V. Uhl see ass. record Book 17, 184

The right to water hereby confirmed and established is limited to irrigation and the use is restricted to the place where acquired and to the purpose for which acquired; rights for irrigation not to exceed one cubic foot per second for each seventy acres of land for which appropriation is herein determined and established.

IN TESTIMONY WHEREOF, I, A. J. Parshall, President of the State Board of Control, have hereunto set my hand this 17th day of November, A. D. 19 11, and caused the seal of said Board to be hereunto affixed.

ATTEST: LOUISE JAHNEMANN, Secretary.

President

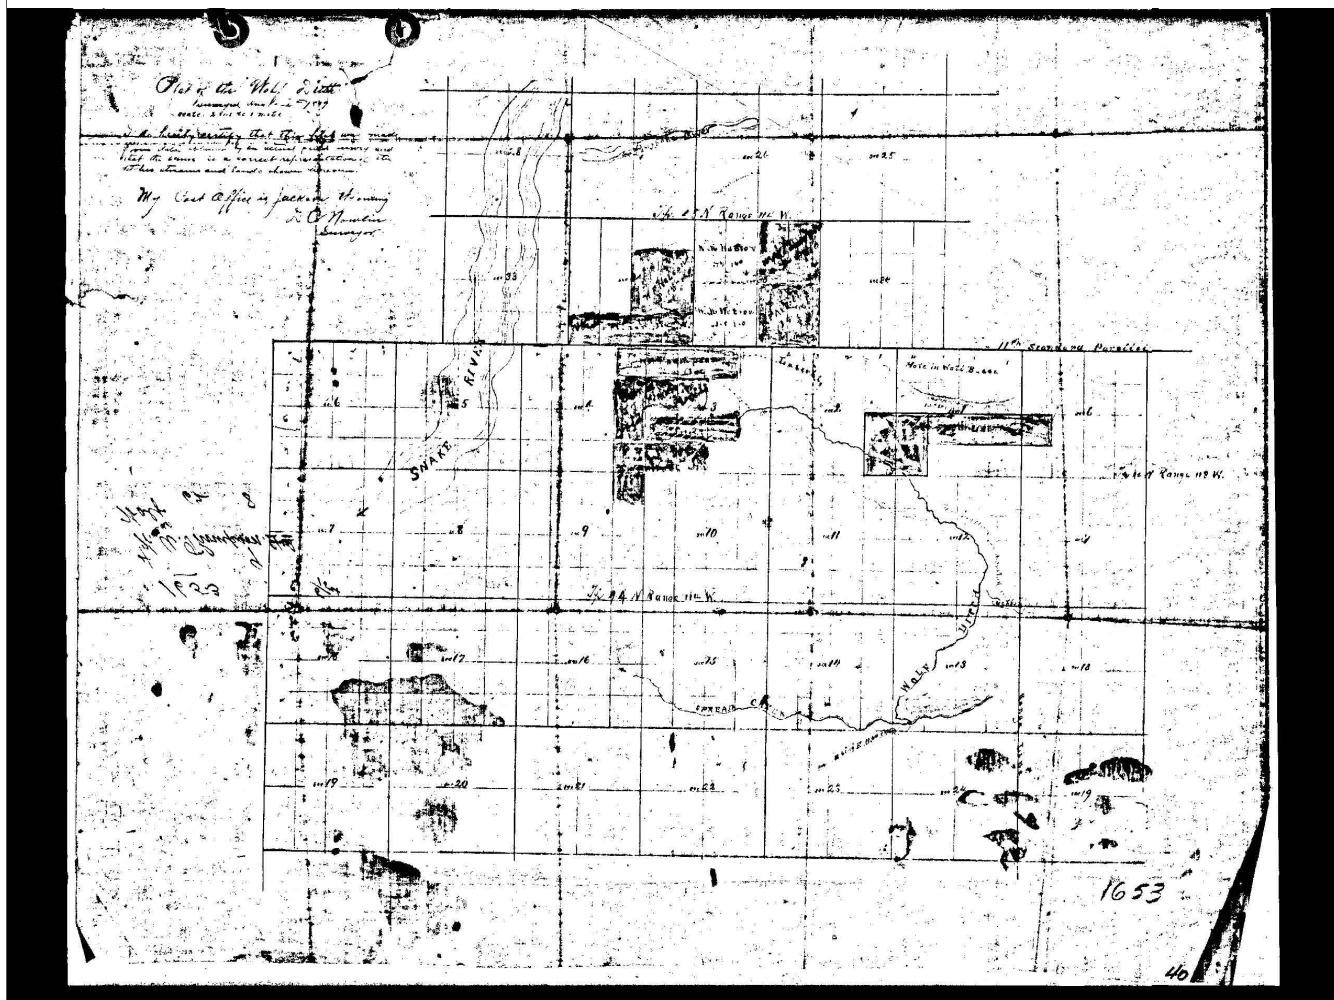

Docket Information

Number of Documents in Docket 16

Documents Dated from 8/4/1897 to 11/17/1911

Docket Compiled: 3/30/2011