WATER-RIGHT DOCKET

Grand Teton National Park

Docket No: 136

ENLARGED WOLFF DITCH. SPREAD CREEK.

Preliminary Docket Information

00-00-0000: water right/source docket information

136

WATER RIGHT RECORD

Docket Number 43
Alien WR Number
Water Use Map NP-GT 2174
Sheet Number 6

IDENTIFICATION NO: GRTE R 1 3 4 4 1 1 4 C F 4 3

DITCH/WATER SYSTEM: ENLARGED WOLFF DITCH

SOURCE OF SUPPLY: Spread Creek, tributary of the Snake River

LOCATION:

Legal description and tie:
(Point of Diversion)
Headgate: N 84° 40' E, 1270 feet from the southwest corner of Section 13, Township 44 North, Range 114 West.

WATER RIGHT:

Appropriator: Jackson Hole Reserve, Incorporated

Certificate Record Number: 61-444

Permit Number: 5279 E

Date of priority: December 4, 1940

Quantity of Water: Reservoir Supply Ditch

Purpose: Reservoir Supply Ditch

Irrigate Land Description:

Supply ditch for the Uhl Reservoir, Permit 5380 R.

5

State Water Rights Documentation

12-16-1949: certificate of appropriation of water record for 1940: permit #5279 enl. for reservoir supply, certificate record #61, pag

Certificate of Appropriation of Water

Certificate Record No. 61, Page 444

WHEREAS, Jackson Hole Preserve, Inc. has presented to the Board of Control of the State of Wyoming proof of the appropriation of water from Spread Creek, tributary of Snake River through the Enl. Wolff Ditch under Permit No. 5279 Enl. for reservoir supply for irrigation of the lands herein described, lying and being in Teton County, Wyoming.

NOW KNOW YE, That the State Board of Control, under the provisions of the Statutes of Wyoming, has, by an order duly made and entered on the 16th day of December, A. D. 1949, in Order Record No. 12, Page 46, determined and established the priority and amount of such appropriation as follows:

Name of Appropriator Jackson Hole Preserve, Inc.; Postoffice Address Jackson, Wyoming;

Date of Appropriation December 4, 1940; Total Acreage None;

Amount of Appropriation Reservoir Supply ~~cu. ft. per sec.; Description of land to be irrigated and for which this appropriation is determined and established:~~


TWP.	RANGE	SEC.	NE¼	NW¼	SW¼	SE¼	NE¼	NW¼	SW¼	SE¼	NE¼	NW¼	SW¼	SE¼	NE¼	NW¼	SW¼	SE¼	TOTAL
SUPPLY DITCH FOR THE UHL RESERVOIR, PERMIT NO. 5280 E.S.																			

The right to water hereby confirmed and established is limited to ~~irrigation~~ the amount beneficially used to supply the Uhl Reservoir, Permit 5300 E. and the use is restricted to the place where acquired and to the purpose for which acquired; ~~rights for irrigation not to exceed one cubic foot of water per second for each seven acres of land to which the appropriation is herein determined and established, except when there is surplus water in the stream as provided by Sections 71-216 to 71-224, Wyoming Compiled Statutes, 1945.~~

IN TESTIMONY WHEREOF, I, L. C. BISHOP, President of the State Board of Control, have hereunto set my hand this 16th day of December, A. D. 1949, and caused the seal of said Board to be hereunto affixed.

Earl Hoff — Secretary

L. C. Bishop — President

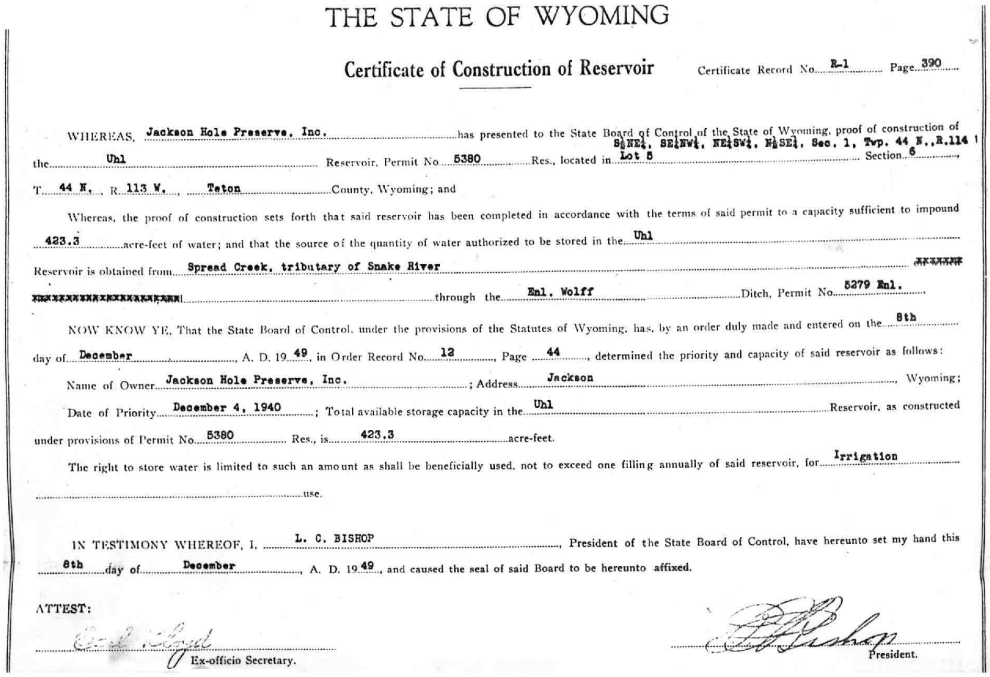

THE STATE OF WYOMING

Certificate of Construction of Reservoir Certificate Record No. R-1 Page 390

WHEREAS, Jackson Hole Preserve, Inc. has presented to the State Board of Control of the State of Wyoming, proof of construction of the Uhl Reservoir, Permit No. 5380 Res., located in Lot 5 (S½NE¼, SE¼NW¼, NE¼SW¼, N½SE¼, Sec. 1, Twp. 44 N., R.114 W.) Section 6, T. 44 N., R. 113 W., Teton County, Wyoming; and

Whereas, the proof of construction sets forth that said reservoir has been completed in accordance with the terms of said permit to a capacity sufficient to impound 423.3 acre-feet of water; and that the source of the quantity of water authorized to be stored in the Uhl Reservoir is obtained from Spread Creek, tributary of Snake River through the Enl. Wolff Ditch, Permit No. 5279 Enl.

NOW KNOW YE, That the State Board of Control, under the provisions of the Statutes of Wyoming, has, by an order duly made and entered on the 8th day of December, A. D. 19 49, in Order Record No. 12, Page 44, determined the priority and capacity of said reservoir as follows:

Name of Owner Jackson Hole Preserve, Inc.; Address Jackson, Wyoming;

Date of Priority December 4, 1940; Total available storage capacity in the Uhl Reservoir, as constructed under provisions of Permit No. 5380 Res., is 423.3 acre-feet.

The right to store water is limited to such an amount as shall be beneficially used, not to exceed one filling annually of said reservoir, for Irrigation use.


IN TESTIMONY WHEREOF, I, L. C. BISHOP, President of the State Board of Control, have hereunto set my hand this 8th day of December, A. D. 19 49, and caused the seal of said Board to be hereunto affixed.

ATTEST:

Ex-officio Secretary.

President.

Maps and Miscellaneous Information

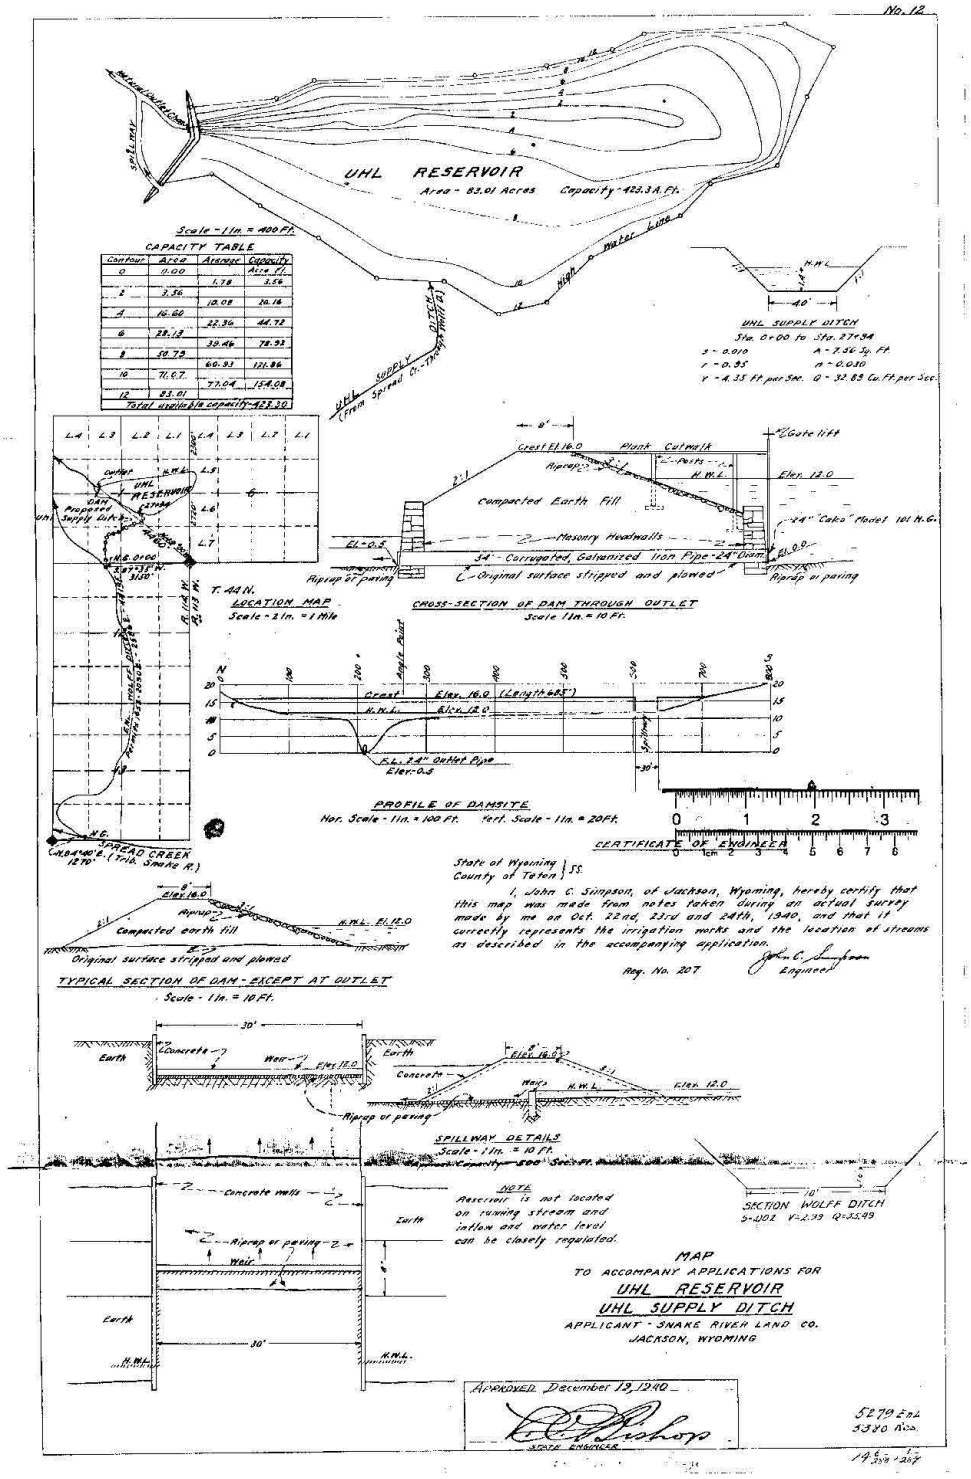

Docket Information

Number of Documents in Docket 4

Documents Dated from 12/19/1940 to 12/16/1949

Docket Compiled: 4/6/2011